


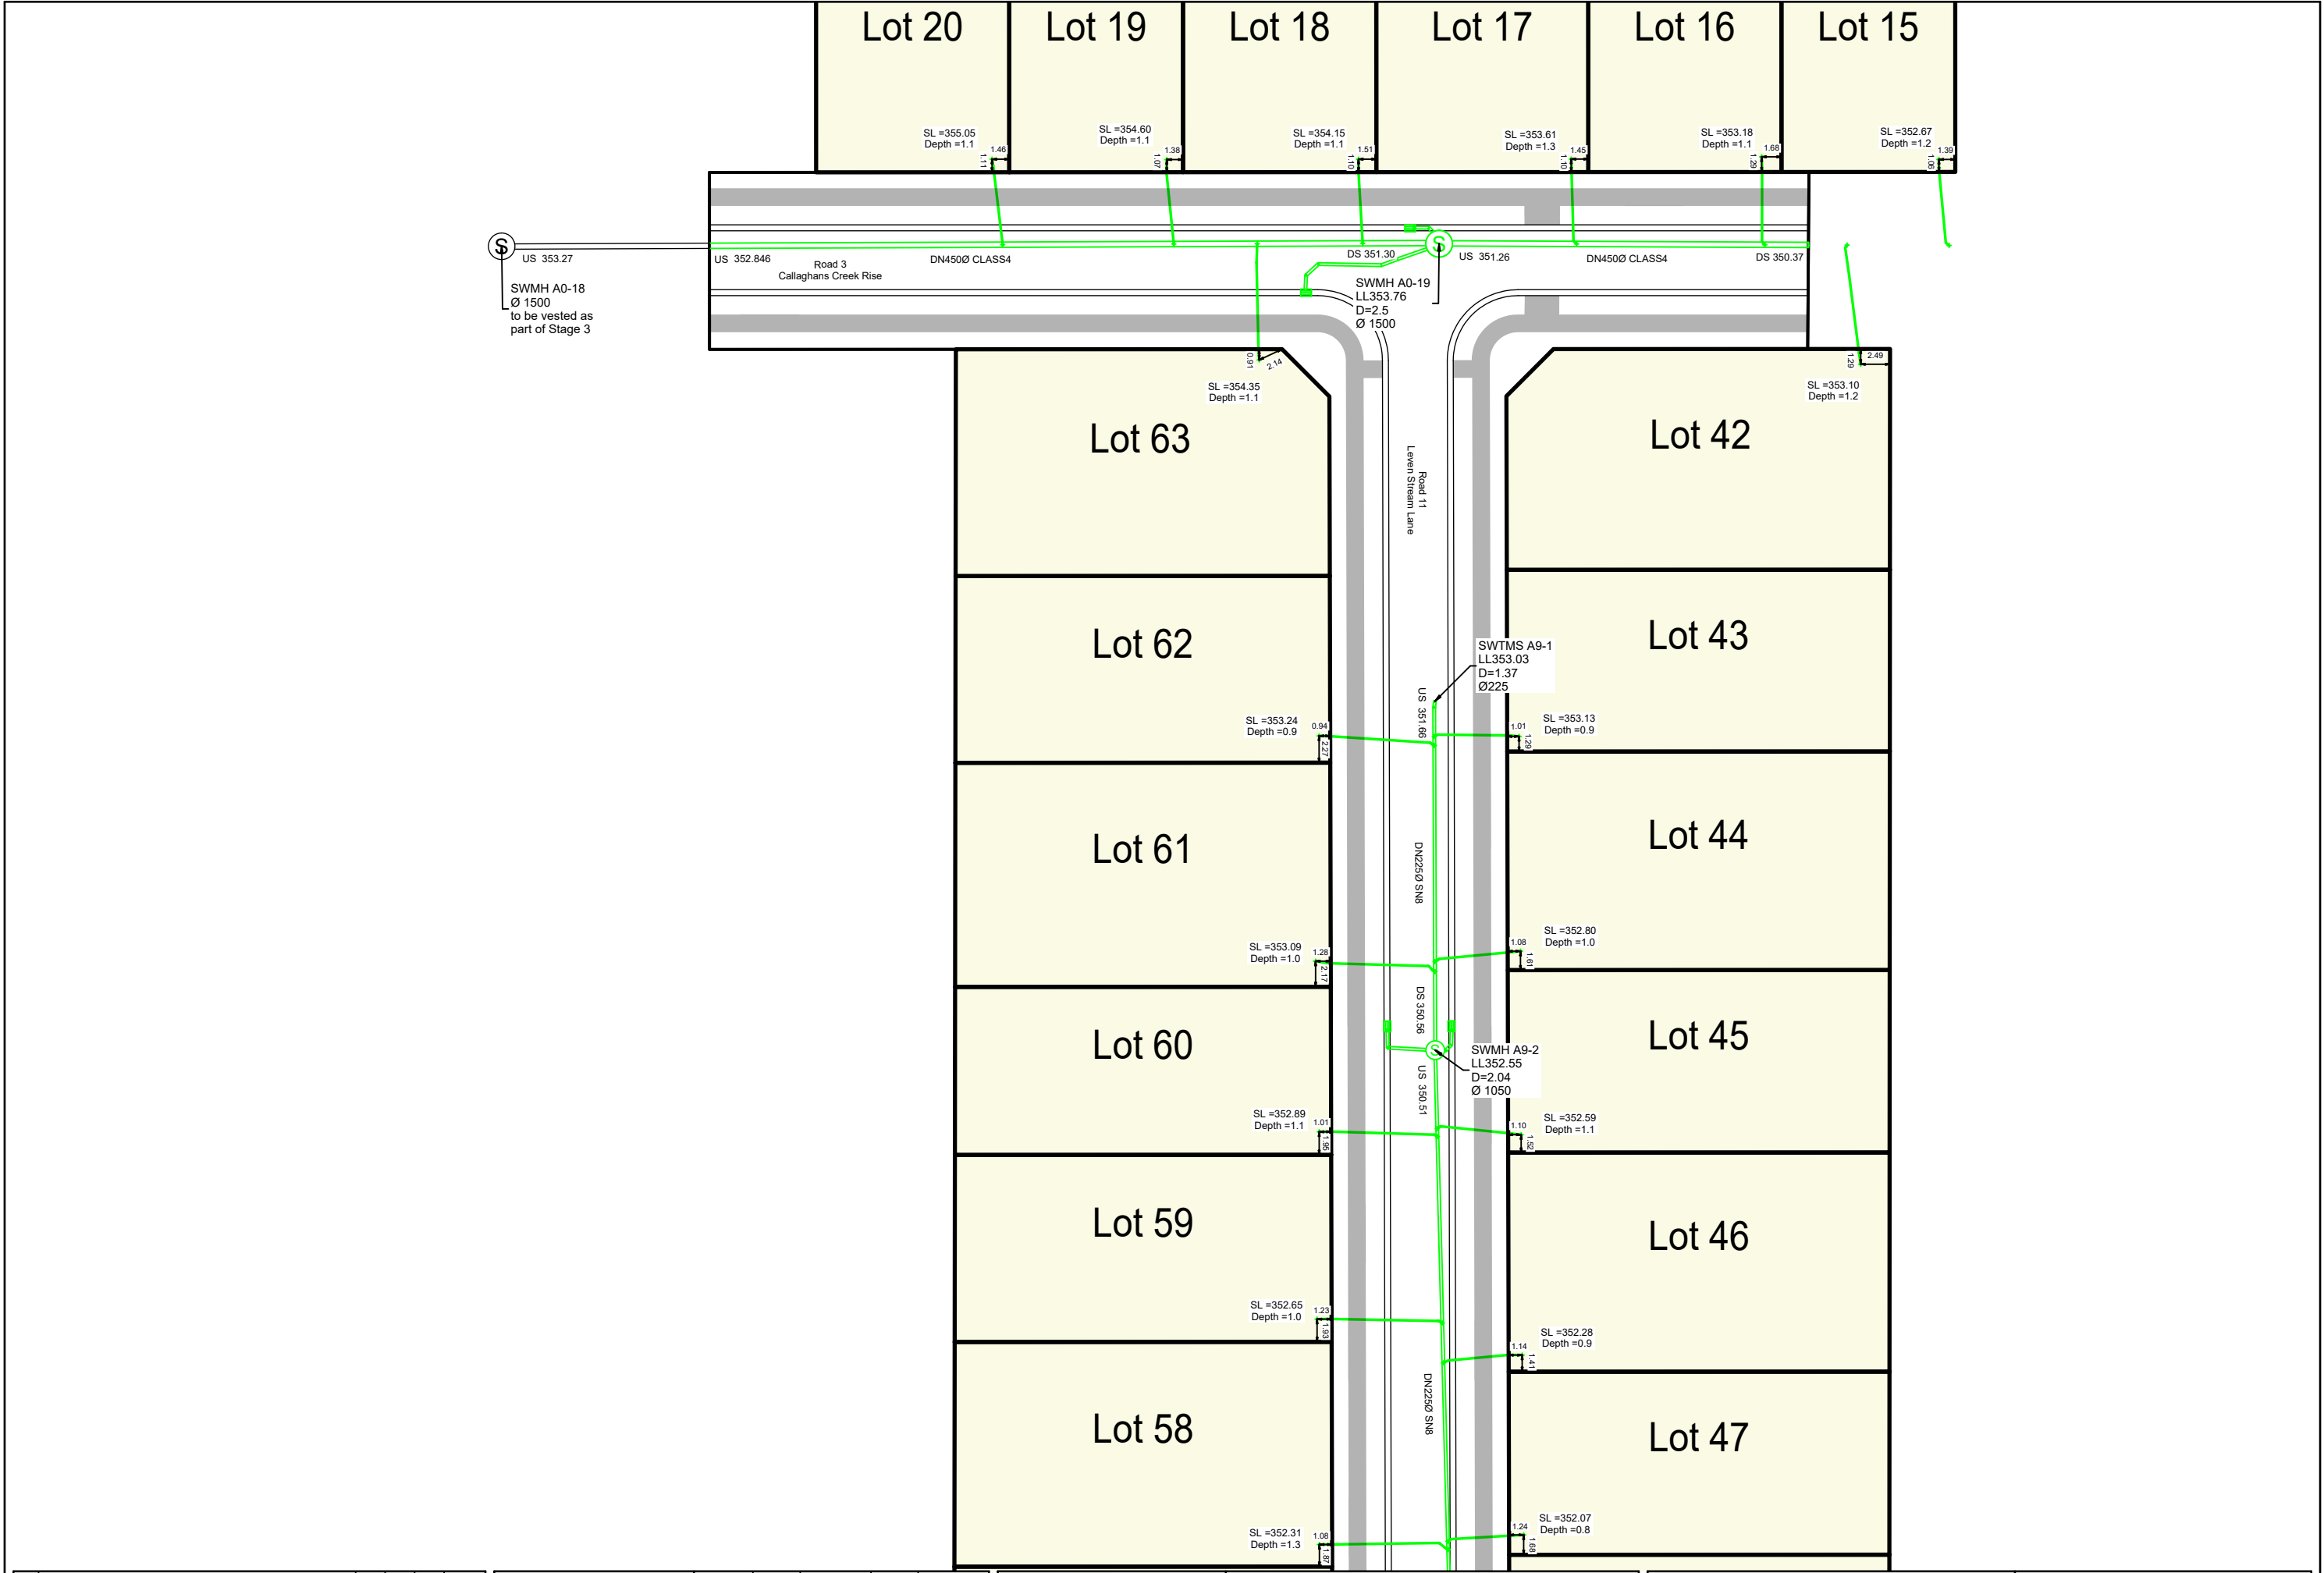

1	Initial Issue	KA	NKA	NKA	17.07.25
No.	Revision	By	Chk	Appd	Date

Original Scale (A1)	Drawn By K Adams	Checked By N Archer
Coordinate System	Linds Peak 2000 EPSG:2127	
Origin Name	PIN 1 SO 559636	
Origin Coordinate	806736.288 mN 375397.584 mE	
Origin of Levels	338.832 m VD2016	
Reduced Scale (A3)	1 : 500	

Client:

LANDPRO.


Project:


21091 Stage 2 As-Built
RM220913 Sg. 2/2

Title:

WFH Properties Ltd
Pembroke Heights
WANAKA

Discipline	Stormwater	Page 1 of 9
Drawing No.	207	Rev. 1

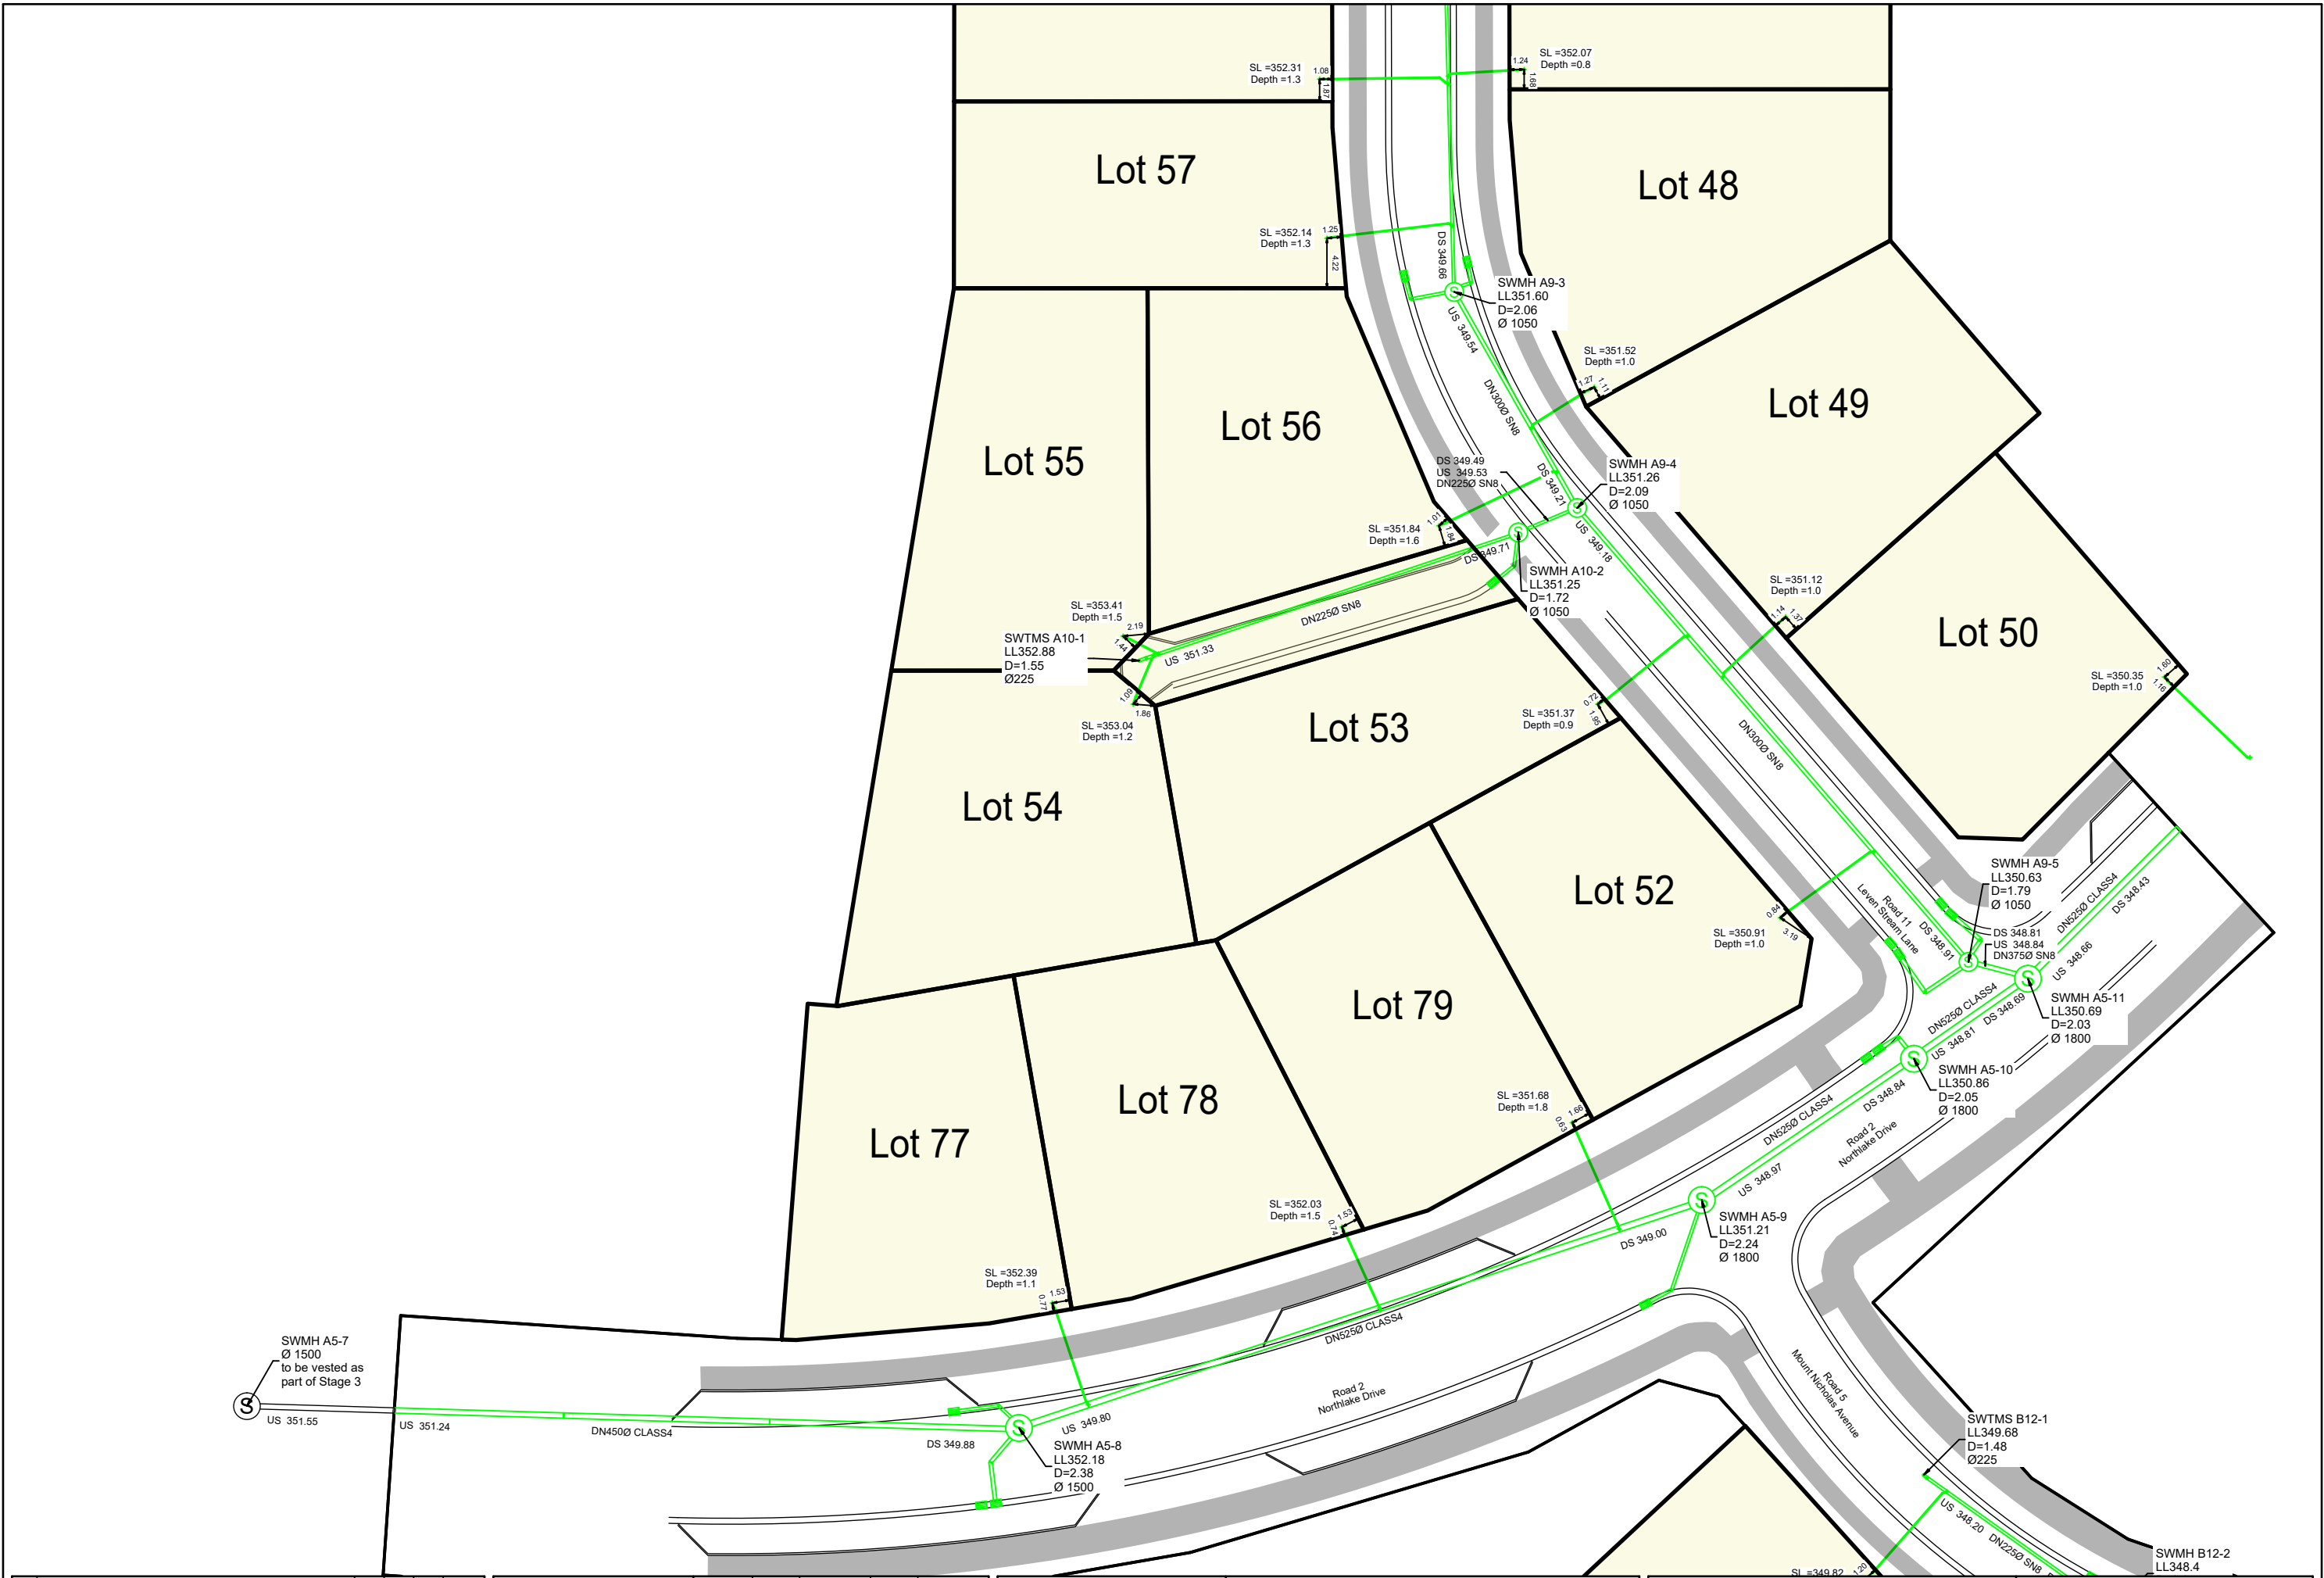

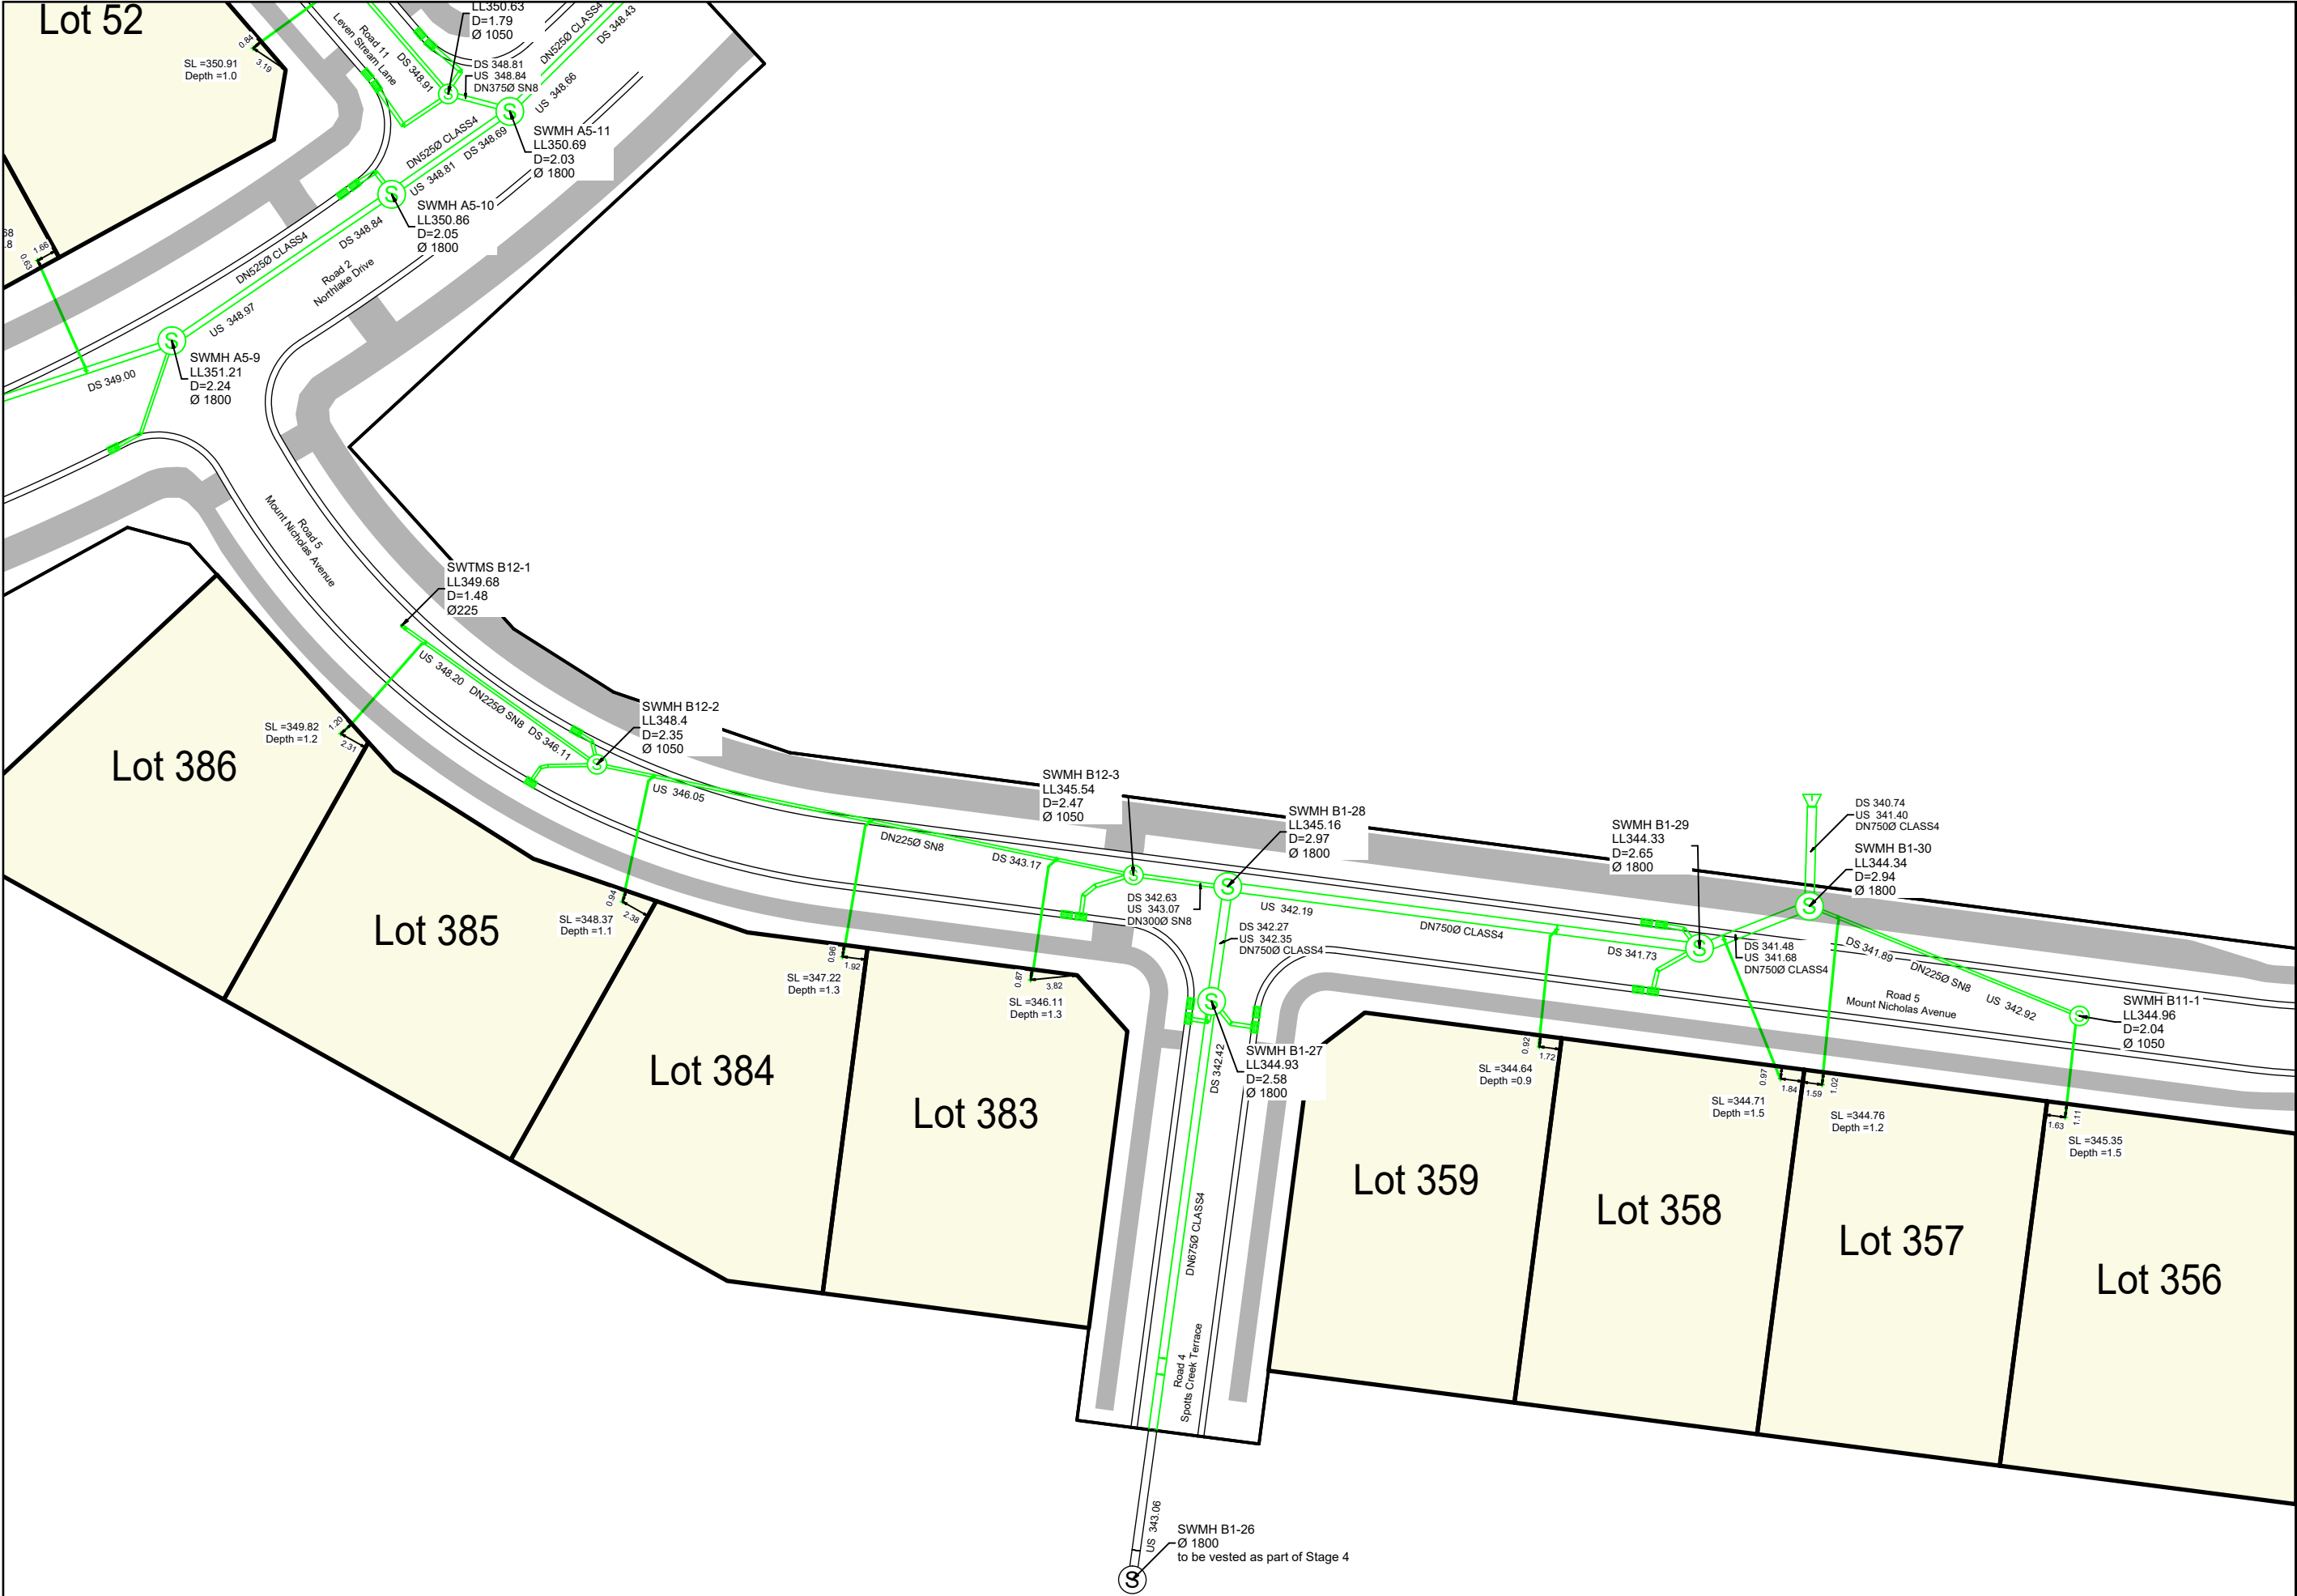

1	Initial Issue		KA	NKA	NKA
No.	Revision		By	Chk	Appd
					Date
					17.07.25

Original Scale (A1)	Drawn By K Adams	Checked By N Archer
Reduced Scale (A3)	Coordinate System	Linds Peak 2000 EPSG:2127
1 : 500	Origin Name	PIN 1 SO 559636
	Origin Coordinate	806736.288 mN 375397.584 mE
	Origin of Levels	338.832 m VD2016

Client:

LANDPRO.

Project:

21091 Stage 2 As-Built
RM220913_Sg_2/2

Title:

WFH Properties Ltd
Pembroke Heights
WANAKA

Discipline


Stormwater Page 3 of 9

Drawing No.

207

Rev.

1

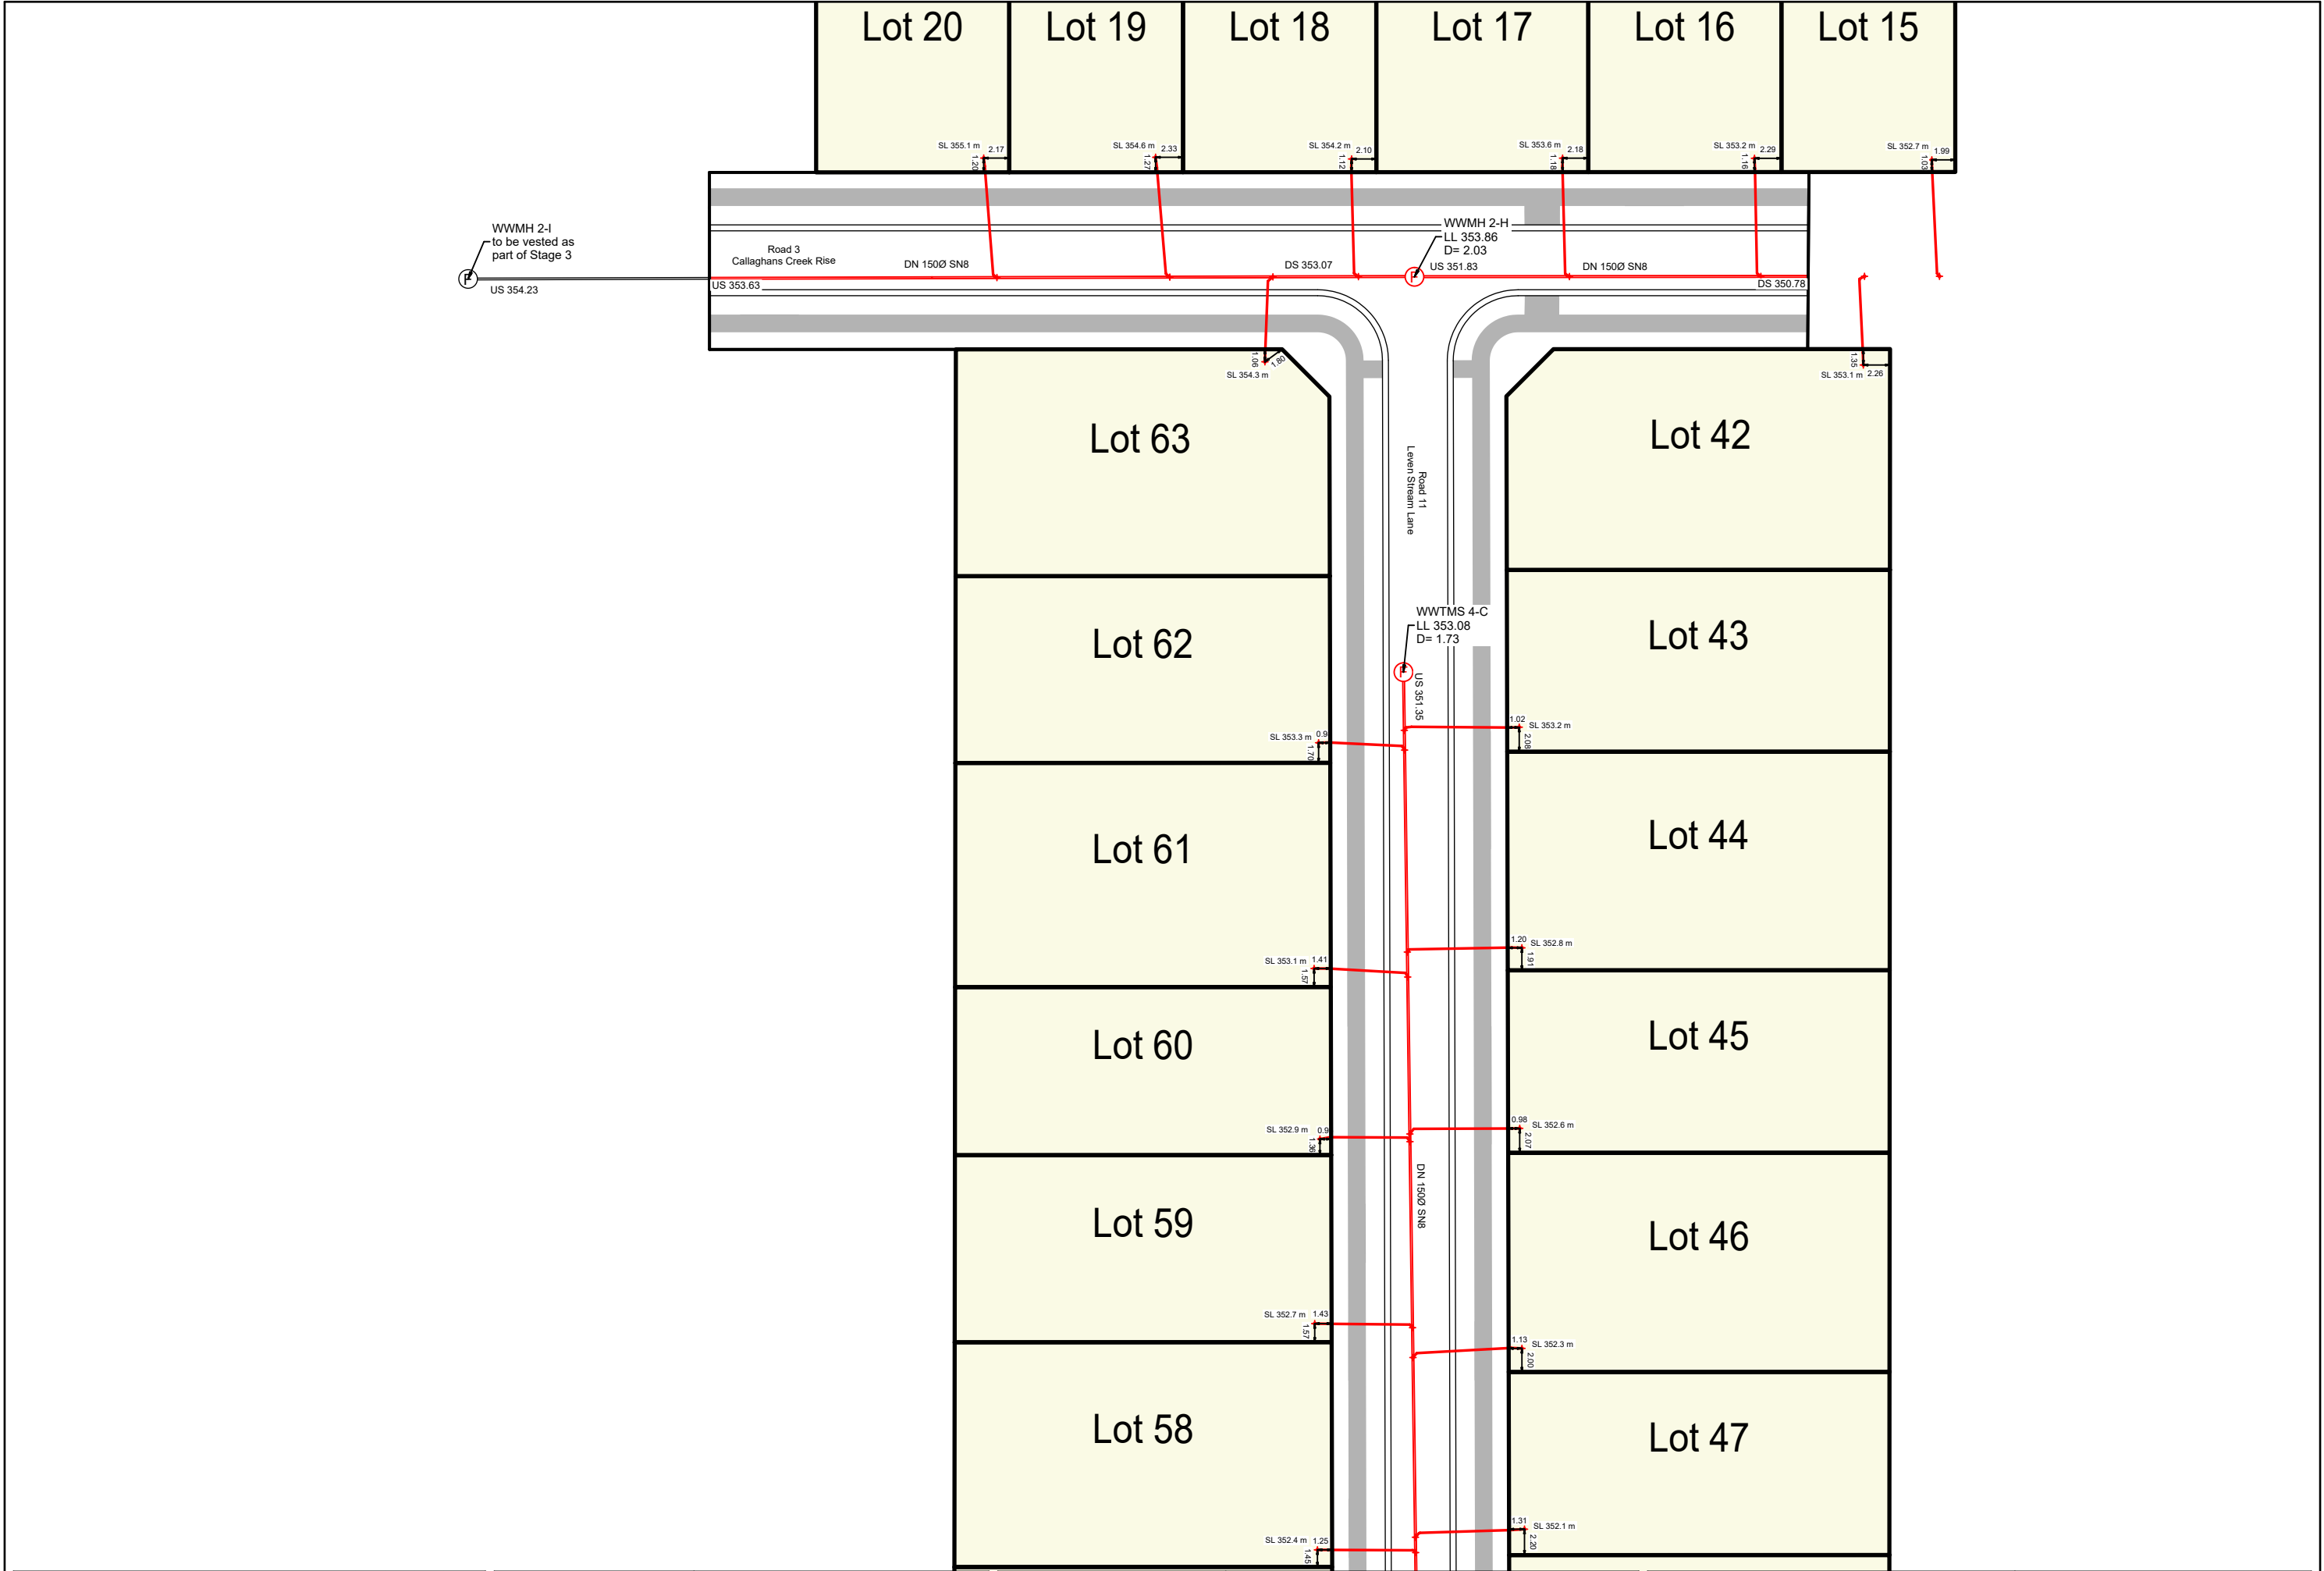

1	Initial Issue	KA	NKA	NKA	17.07.25
No.	Revision	By	Chk	Appd	Date

Original Scale (A1)	Drawn By K Adams	Checked By N Archer
Reduced Scale (A3)	Coordinate System Linds Peak 2000 EPSG:2127	Origin Name PIN 1 SO 559636
1 : 500	Origin Coordinate 806736.288 mN 375397.584 mE	Origin of Levels 338.832 m VD2016

Client:

LANDPRO.

Project:

21091 Stage 2 As-Built
RM220913_Sg_2/2

Title:

WFH Properties Ltd
Pembroke Heights
WANAKA

Discipline

Sewer


Page 4 of 9

Drawing No.

207

Rev.

1

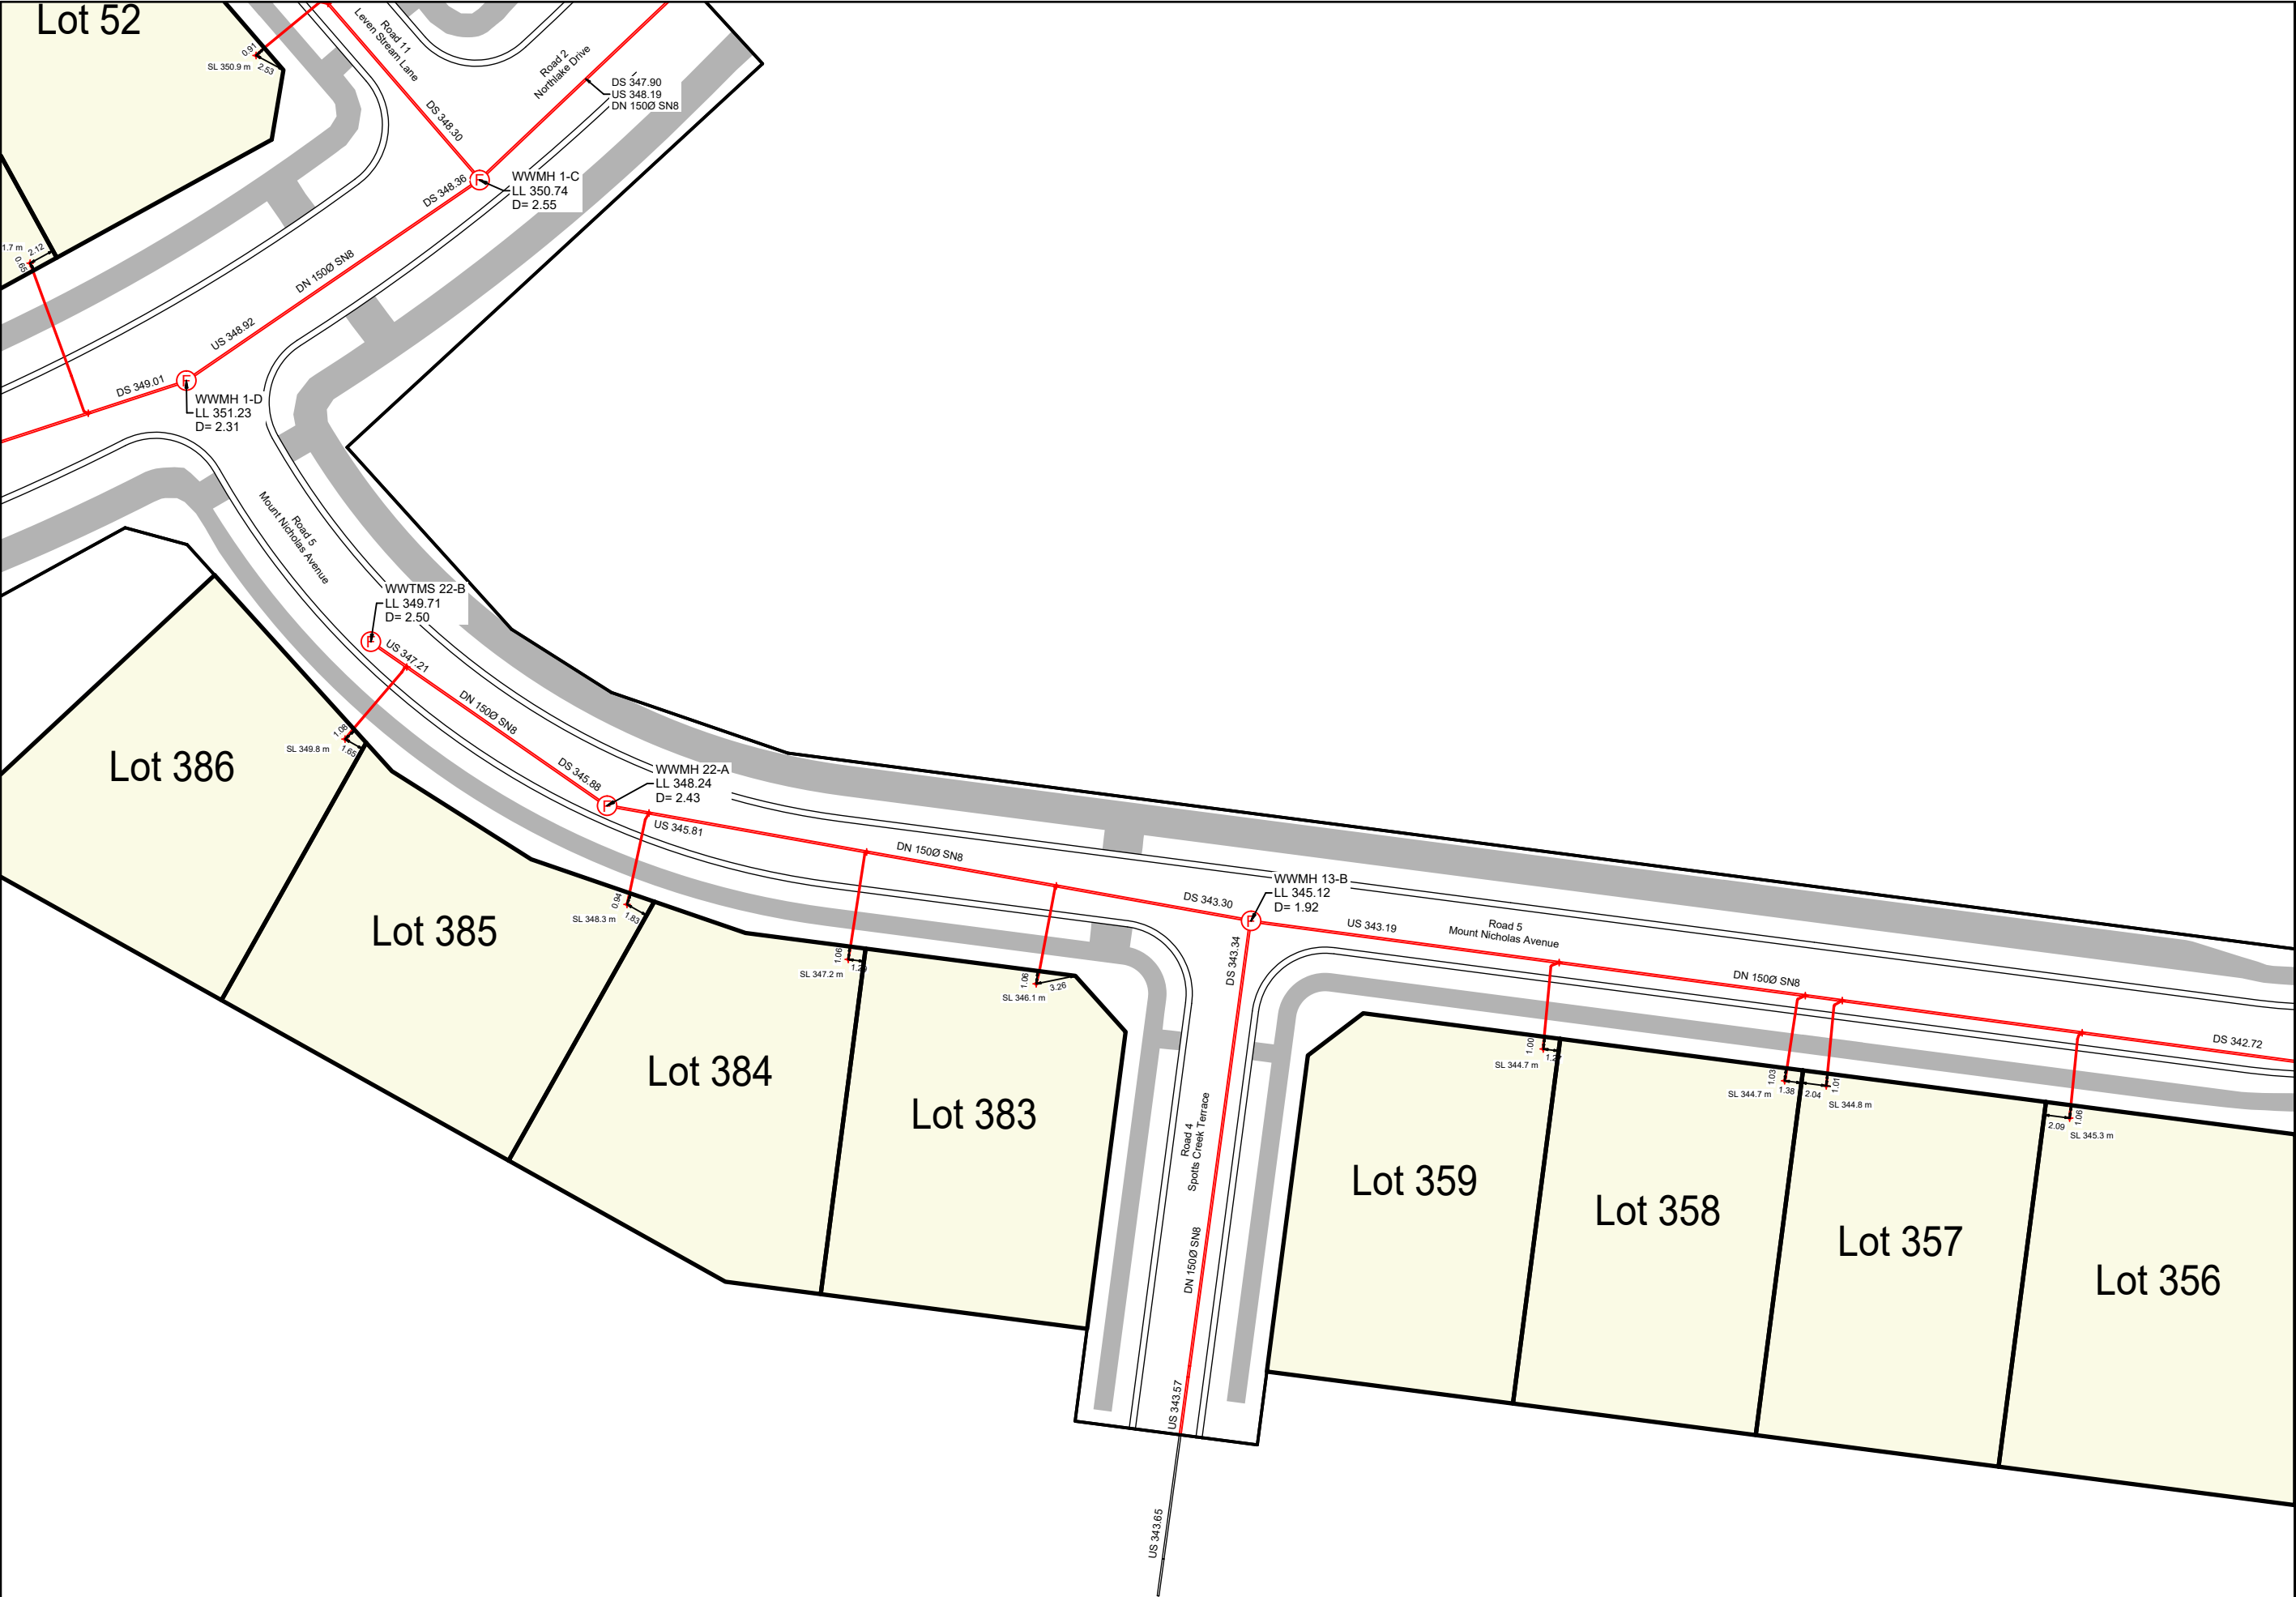

1	Initial Issue	KA	NKA	NKA	17.07.25
No.	Revision	By	Chk	Appd	Date

Original Scale (A1)	Drawn By K Adams	Checked By N Archer
Reduced Scale (A3)	Coordinate System Linds Peak 2000 EPSG:2127	Origin Name PIN 1 SO 559636
1 : 500	Origin Coordinate 806736.288 mN 375397.584 mE	Origin of Levels 338.832 m VD2016

Client:

LANDPRO.


Project:

21091 Stage 2 As-Built
RM220913_Sg_2/2

Title:

WFH Properties Ltd
Pembroke Heights
WANAKA

Discipline	Sewer	Page 6 of 9
Drawing No.	207	Rev. 1

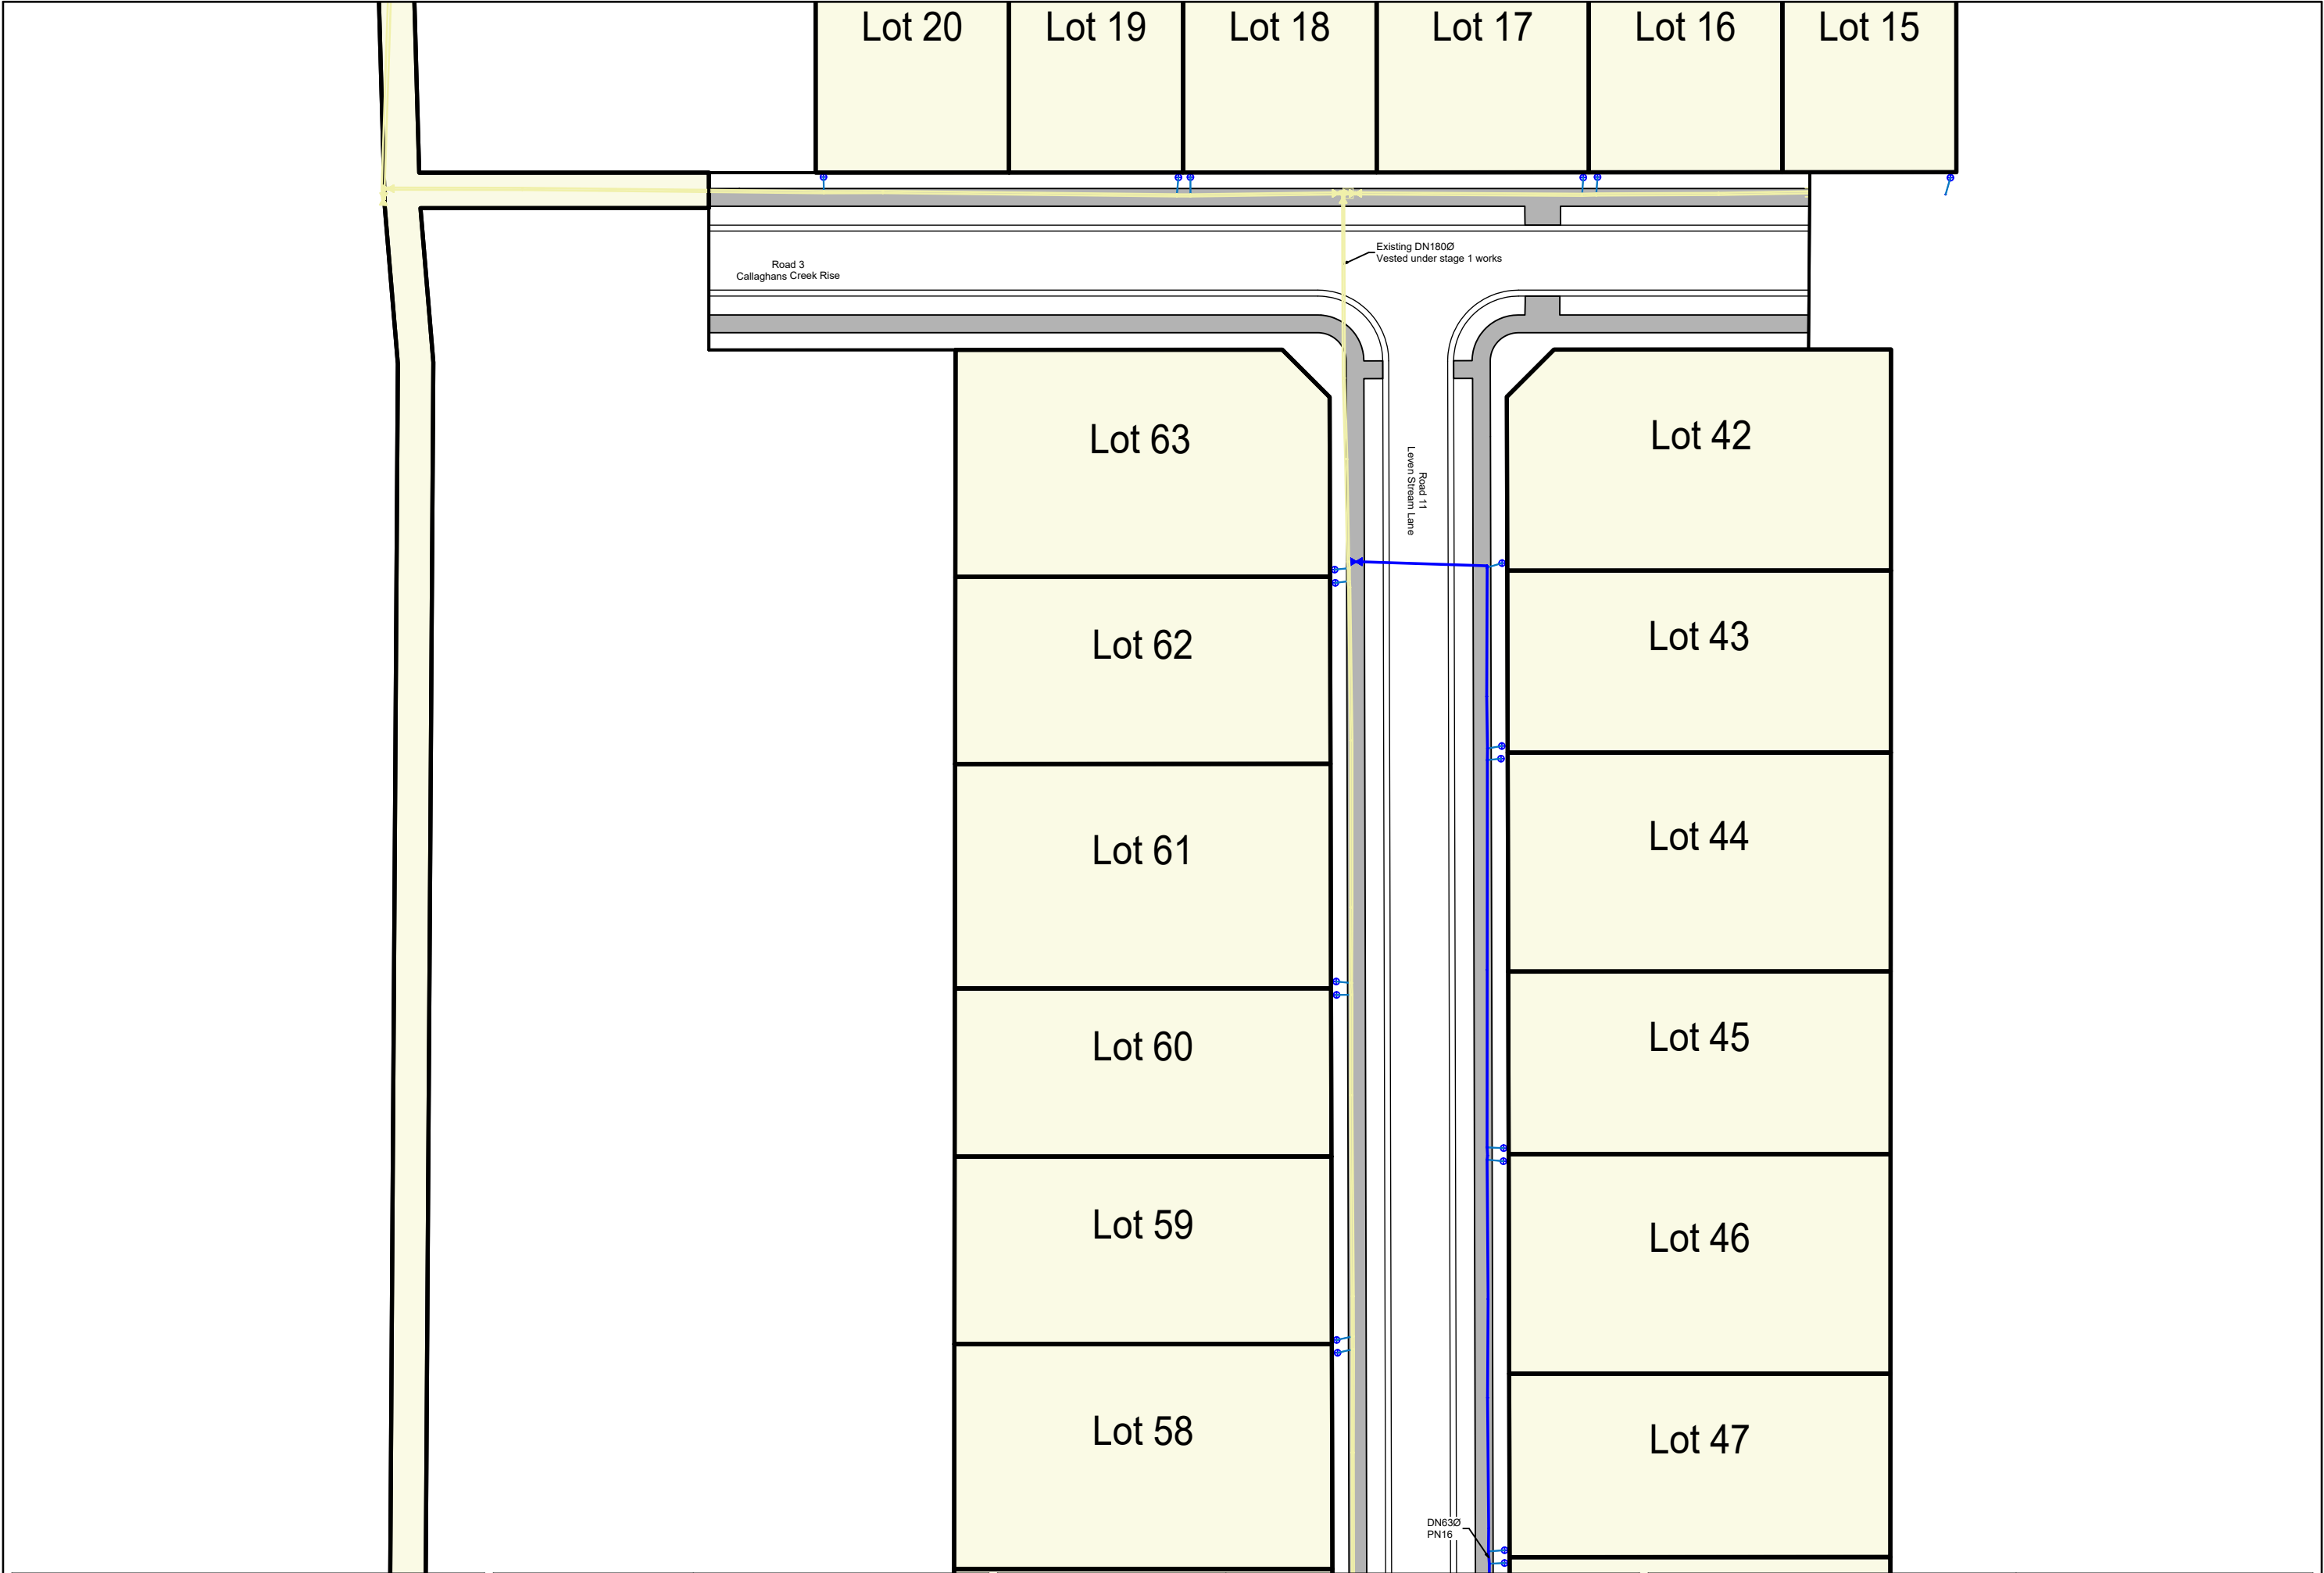

1	Initial Issue	KA	NKA	NKA	17.07.25
No.	Revision	By	Chk	Appd	Date

Original Scale (A1)	Drawn By K Adams	Checked By N Archer
Reduced Scale (A3)	Coordinate System Linds Peak 2000 EPSG:2127	
1 : 500	Origin Name PIN 1 SD 559636	
	Origin Coordinate 806736.288 mN 375397.584 mE	
	Origin of Levels 338.832 m VD2016	

Client:

LANDPRO.


Project:

21091 Stage 2 As-Built
RM220913 Sg. 2/2

Title:

WFH Properties Ltd
Pembroke Heights
WANAKA

Discipline	Water	Page 7 of 9
Drawing No.	207	Rev. 1

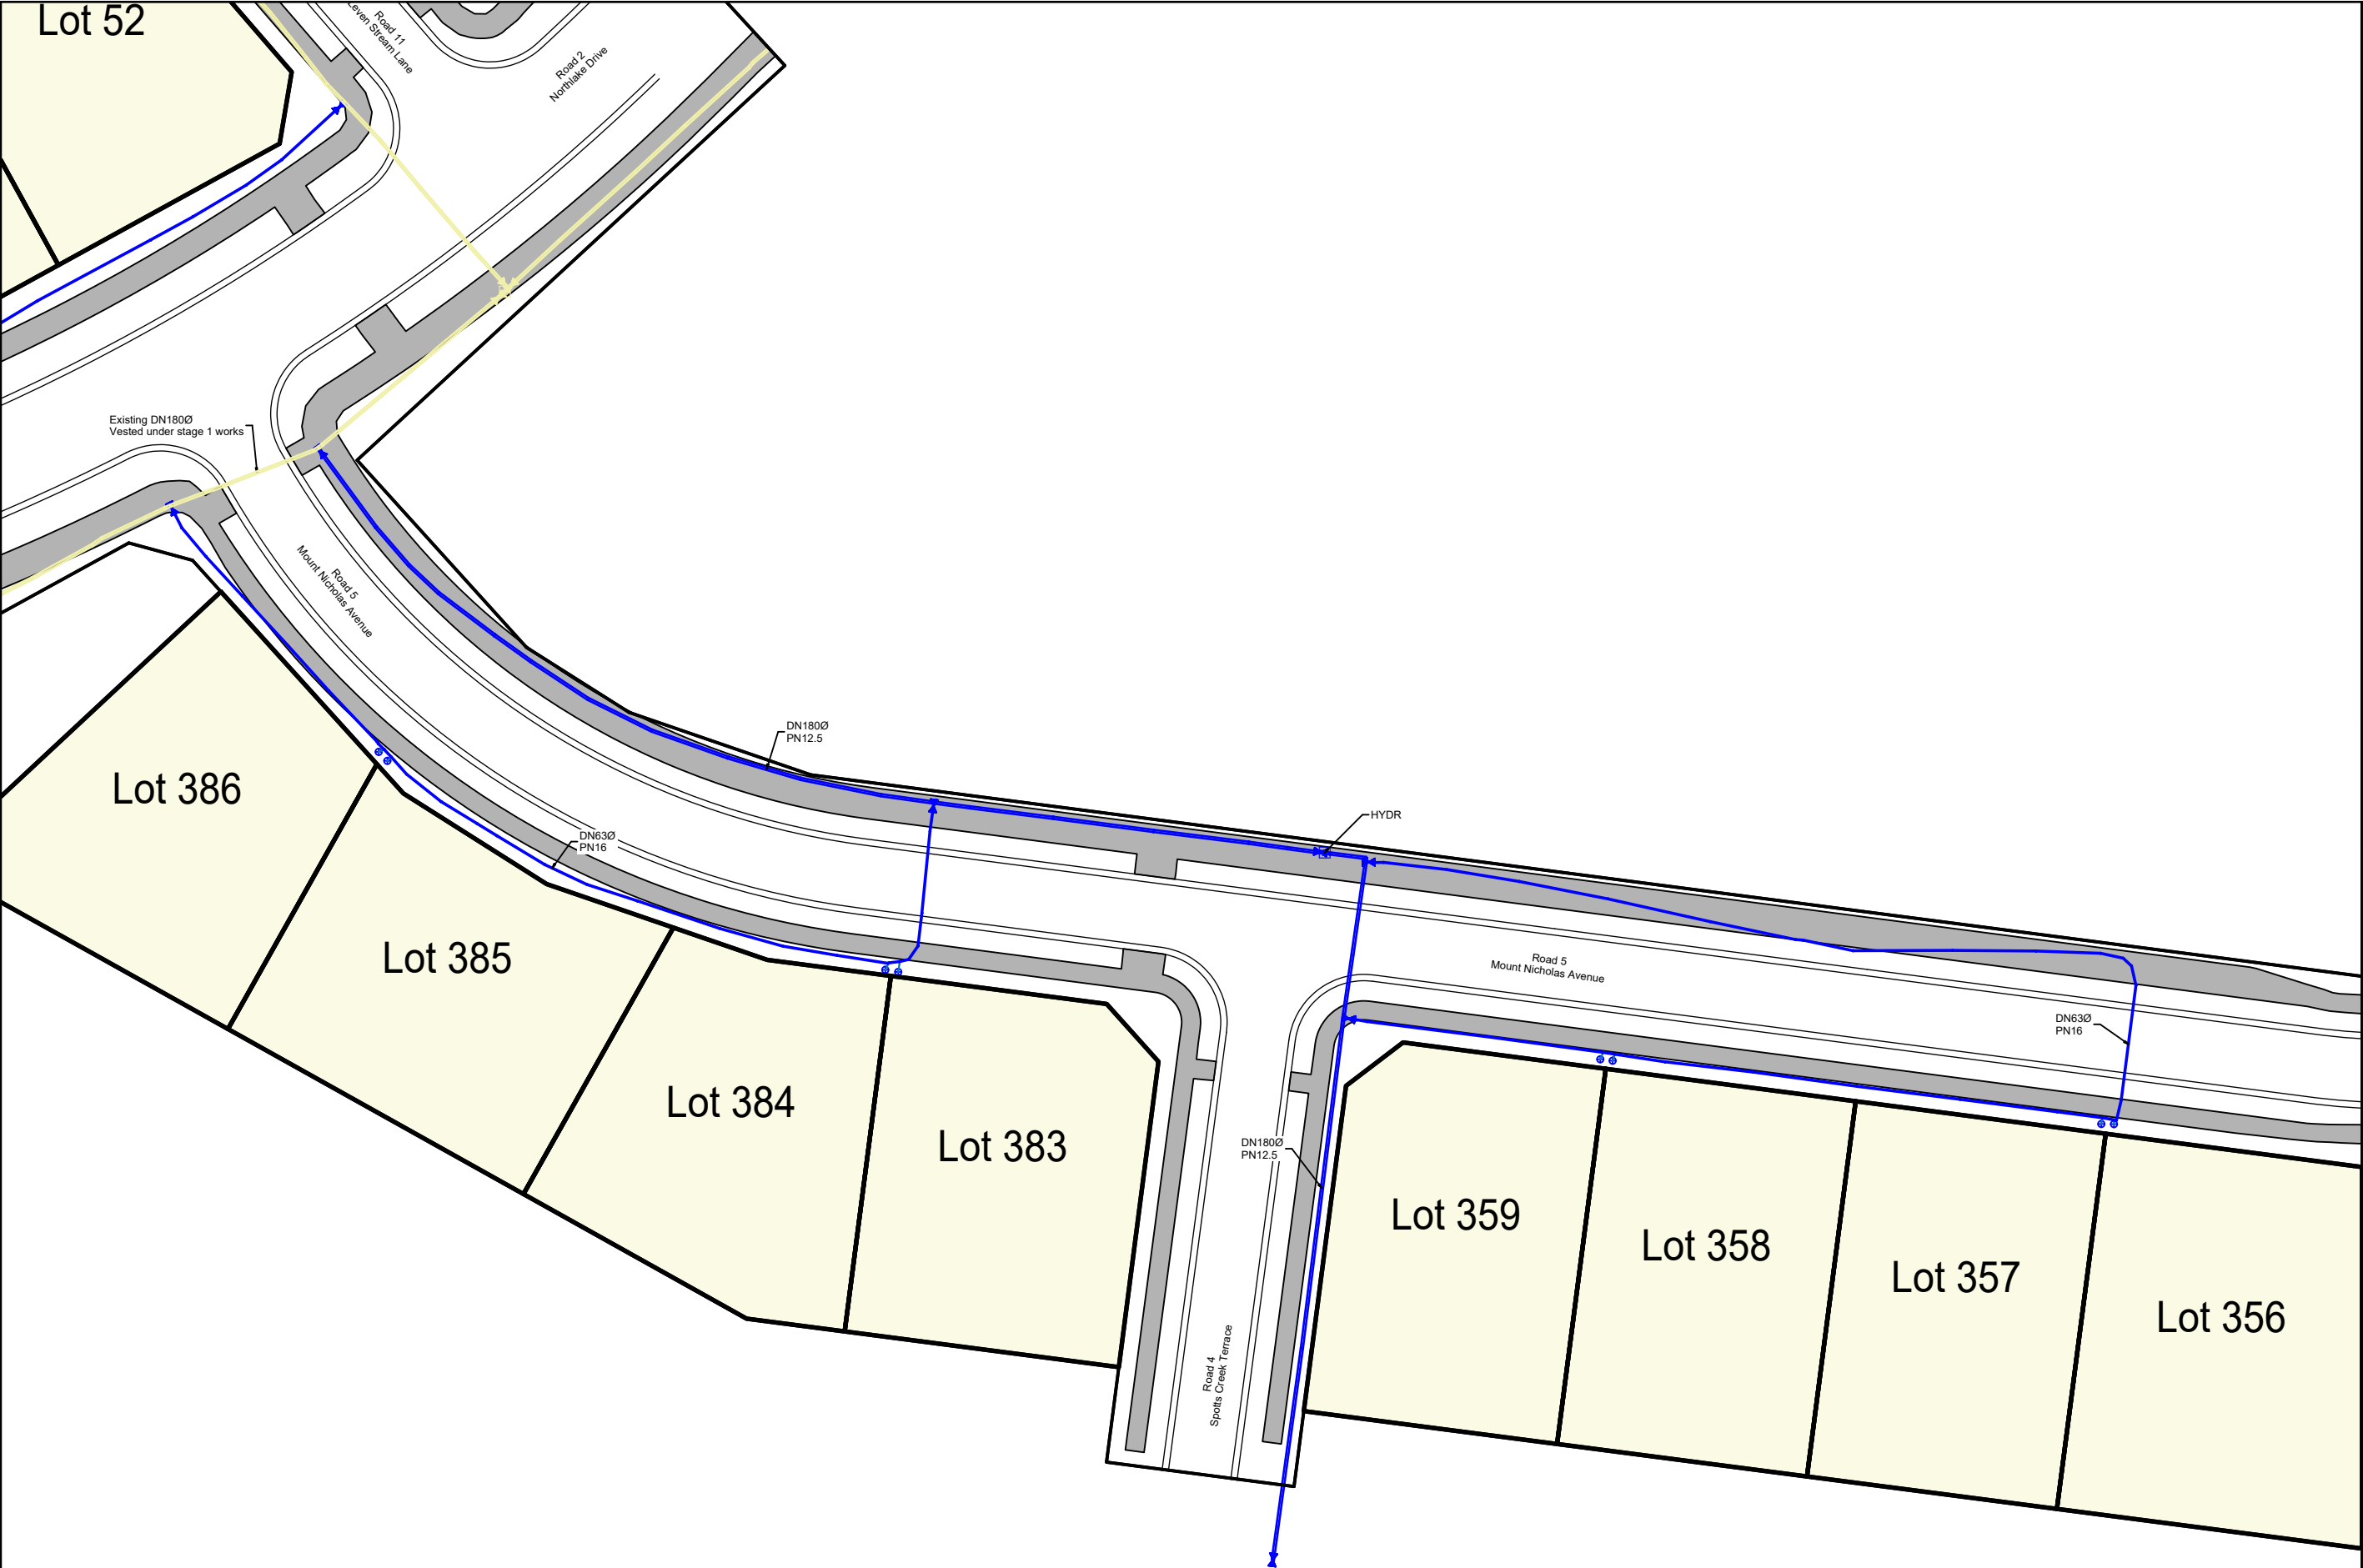

1	Initial Issue	KA	NKA	NKA	17.07.25
No.	Revision	By	Chk	Appd	Date

Original Scale (A1)	Drawn By K Adams	Checked By N Archer
Reduced Scale (A3)	Coordinate System Linds Peak 2000 EPSG:2127	
1 : 500	Origin Name PIN 1 SO 559636	
	Origin Coordinate 806736.288 mN 375397.584 mE	
	Origin of Levels 338.832 m VD2016	

Client:

LANDPRO.

Project:

21091 Stage 2 As-Built
RM220913_Sg_2/2

Title:

WFH Properties Ltd
Pembroke Heights
WANAKA

Discipline	Water	Page 9 of 9
Drawing No.	207	Rev. 1